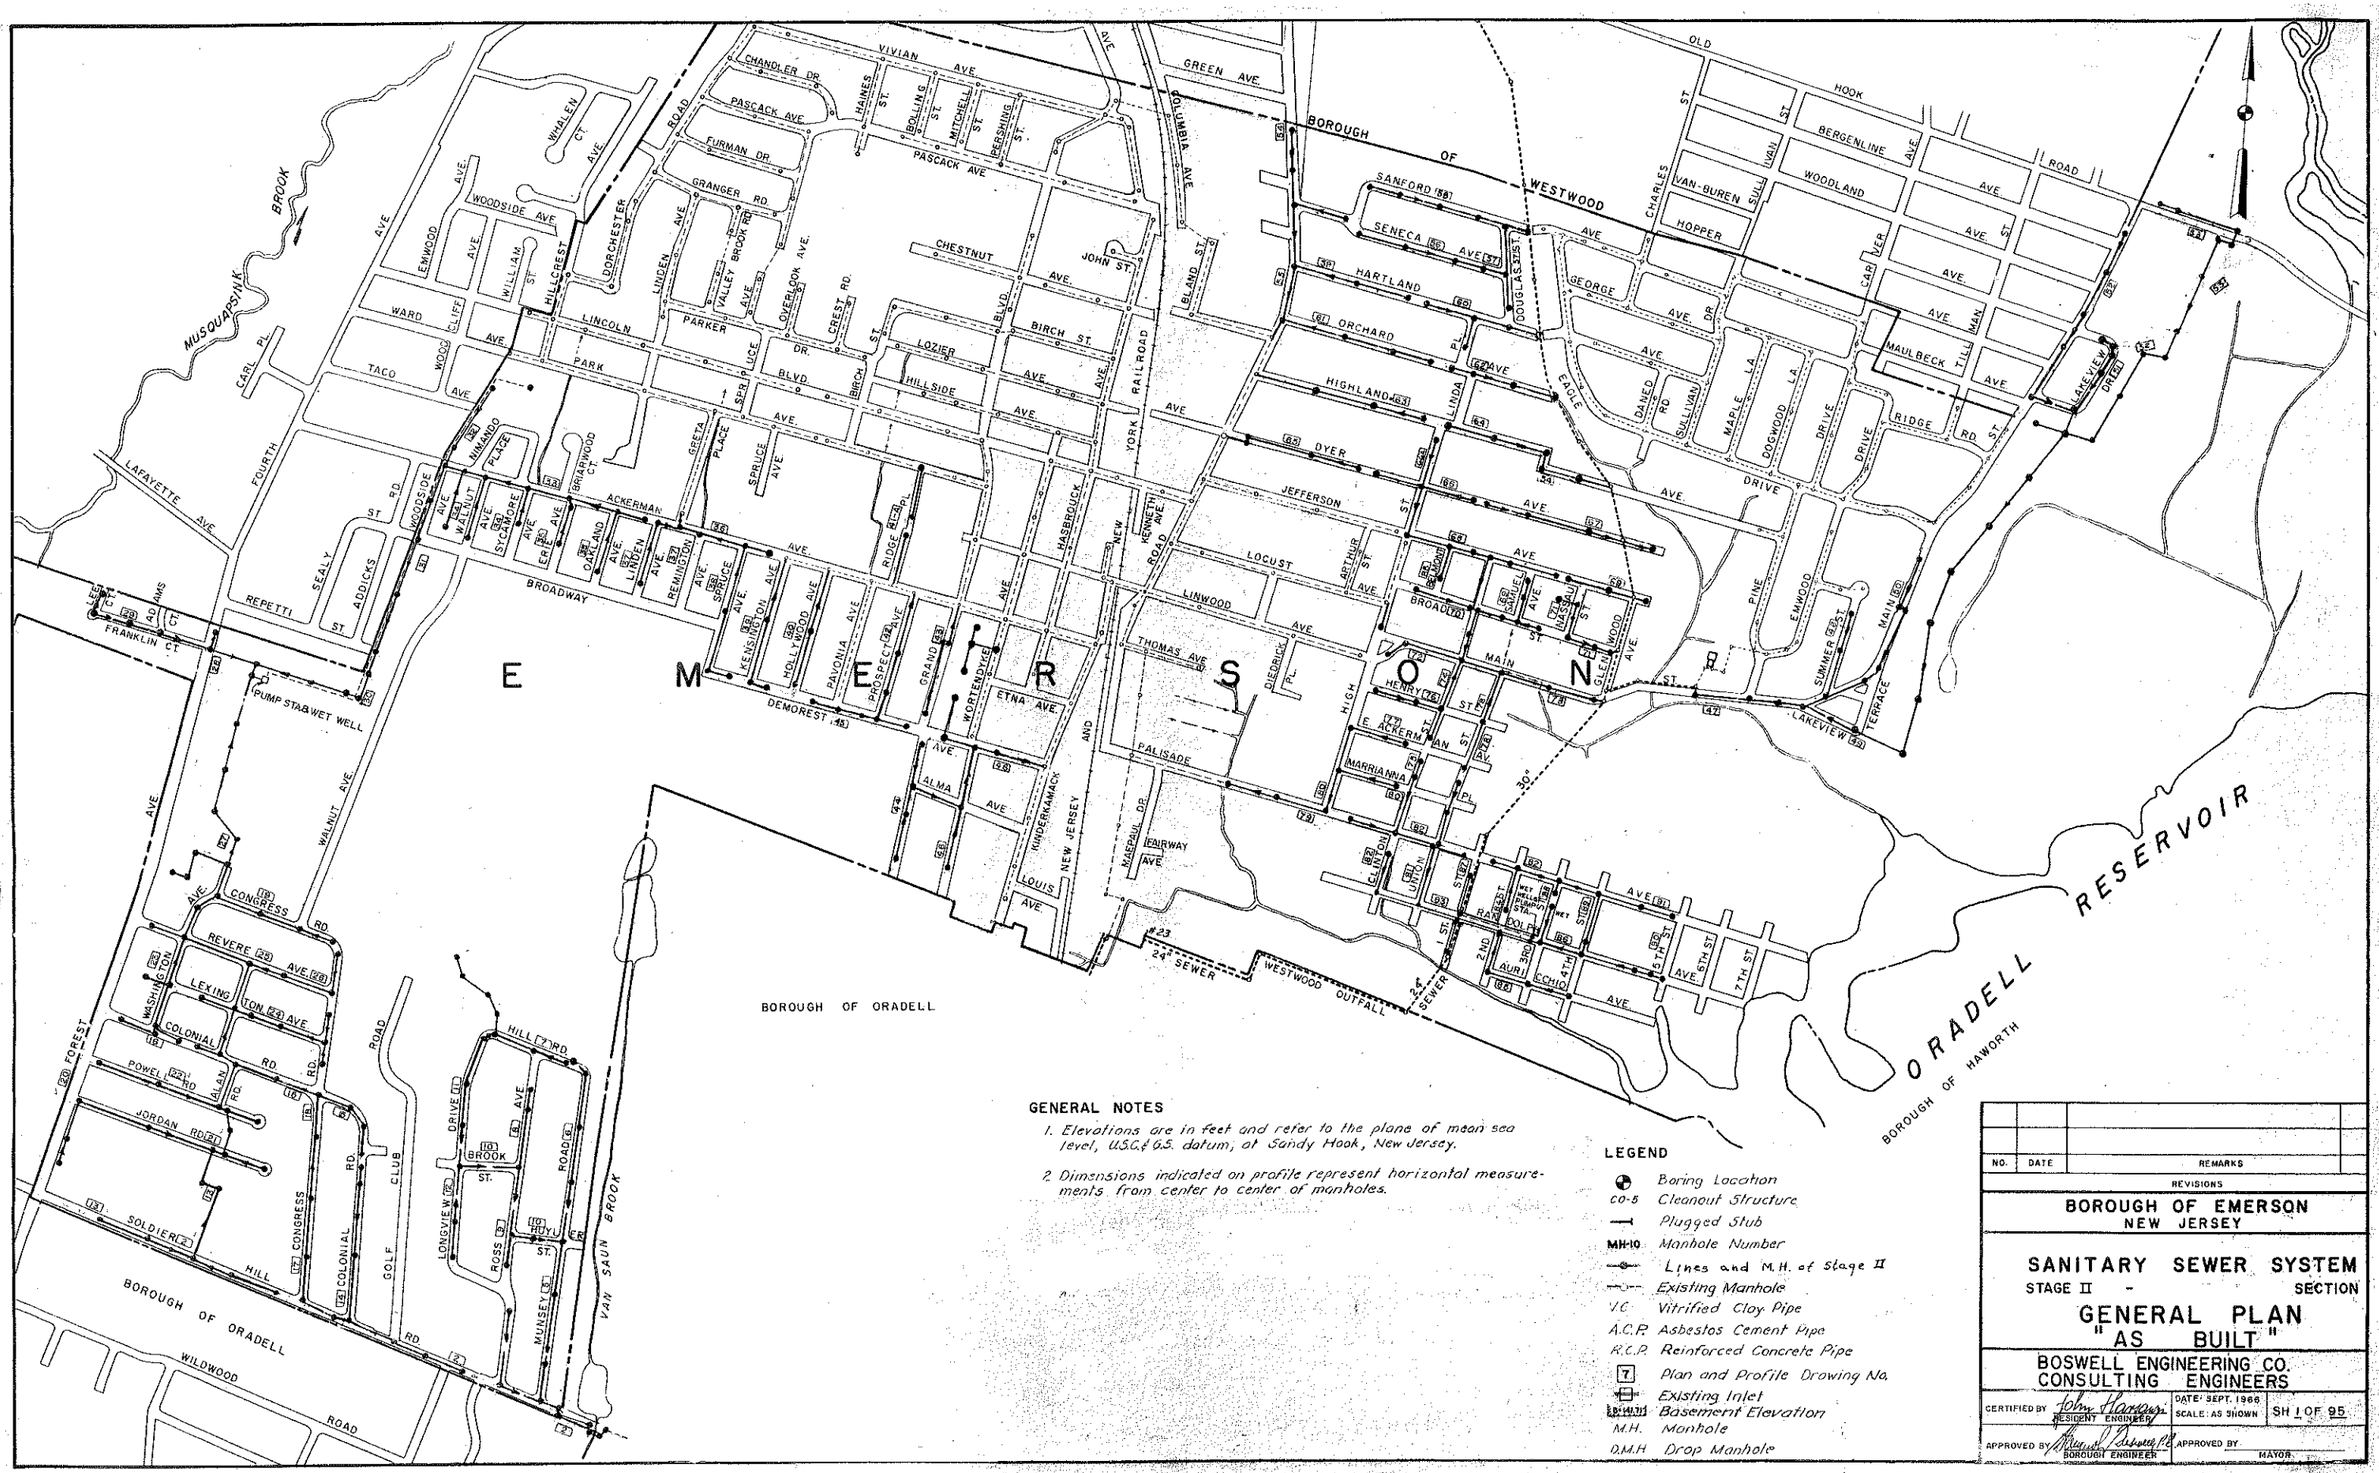

GENERAL NOTES

1. Elevations are in feet and refer to the plane of mean sea level, U.S.C.& G.S. datum, at Sandy Hook, New Jersey.
2. Dimensions indicated on profile represent horizontal measurements from center to center of manholes.

LEGEND

- Boring Location
- CO-5 Cleanout Structure
- Plugged Stub
- MH-10 Manhole Number
- Lines and M.H. of Stage II
- Existing Manhole
- V.C. Vitrified Clay Pipe
- A.C.P. Asbestos Cement Pipe
- R.C.P. Reinforced Concrete Pipe
- [7] Plan and Profile Drawing No.
- Existing Inlet
- Basement Elevation
- M.H. Manhole
- D.M.H. Drop Manhole

NO.	DATE	REMARKS
		REVISIONS

BOROUGH OF EMERSON
NEW JERSEY

SANITARY SEWER SYSTEM
STAGE II - SECTION

GENERAL PLAN
"AS BUILT"

BOSWELL ENGINEERING CO.
CONSULTING ENGINEERS

CERTIFIED BY John Hanson, RESIDENT ENGINEER — DATE: SEPT. 1966 — SCALE: AS SHOWN — SH 1 OF 95

APPROVED BY Marcel Lessard P.E., BOROUGH ENGINEER — APPROVED BY _____ MAYOR

LOT 6A | LOT 8 | LOT 9 | LOT 10 | LOT 10A | LOT 11A | LOT 11C | LOT 7

MH. NO. 48 | MH. NO. 47 | MH. NO. 46 | MH. NO. 45 | MH. NO. 43 | MH. NO. 42 | MH. NO. 42A

8" ACP CLASS 2400 | 8" ACP CLASS 2400 | 8" ACP CLASS 2400 | 8" ACP CLASS 2400

SOLDIER HILL ROAD

CONGRESS RD.

COLONIAL RD.

SEE SHEET 13

SEE SHEET 14

SEE SHEET 17

SEE SHEET 18

PLAN
1"=50'

MH. NO. 48
TOP = 91.79
FL = 82.89

MH. NO. 47
TOP = 91.91
FL = 82.16
FL = 81.71

MH. NO. 46
TOP = 97.33
FL = 92.05

MH. NO. 45
TOP = 101.72
FL = 101.52

MH. NO. 43
TOP = 116.14
FL = 108.89

MH. NO. 42
TOP = 129.03
FL = 120.53

MH. NO. 42A
TOP = 126.00
FL = 120.03

8" ACP CLASS 2400 GR = 0.43%

8" ACP CLASS 2400 GR = 2.78%

8" ACP CLASS 2400 GR = 2.78%

8" ACP CLASS 2400 GR = 1.27%

L = 259.45'

L = 299.11'

L = 250.92'

L = 247.21'

L = 44.92'

259.45'

292.69'

250.76'

247.21'

44.92'

CHURCH BR.
C. FLOOR 134.34

SEE SHEET 3
ROSS AVE.

SEE SHEET 3
MUNSEY RD.

BOROUGH OF EMERSON

SEE DRAWELL BOROUGH OF EMERSON

BAUVELT DR.

MH. NO. 42

MH. NO. 41
TOP = 132.0
FL = 122.50

MH. NO. 40
TOP = 133.7
FL = 123.30

MH. NO. 39
TOP = 137.2
FL = 132.66

MH. NO. 38
TOP = 132.14
FL = 123.37

DROP MH. NO. 12
TOP = 107.82
FL = 101.52
FL = 97.77

MH. NO. 5
TOP = 98.66
FL = 90.26

MH. NO. 4
TOP = 98.64
FL = 87.09

MH. NO. 3
TOP = 95.63
FL = 88.80

MH. NO. 2
TOP = 94.61
FL = 88.71

MH. NO. 1
TOP = 94.81
FL = 88.46

EAST MH.
TOP = 95.72
FL = 87.63

8" ACP CLASS 2400 GR = 1.12%

8" ACP CLASS 2400 GR = 0.27%

8" ACP CLASS 2400 GR = 7.20%

8" ACP CLASS 2400

L = 304.03'

182.00'

268.00'

244.60'

148.25'

CHURCH BR.
C. FLOOR 134.34

MH. NO. 42

MH. NO. 41

MH. NO. 40

MH. NO. 39

MH. NO. 38

MH. NO. 5

MH. NO. 4

MH. NO. 3

MH. NO. 2

MH. NO. 1

BOROUGH OF EMERSON
BERGEN COUNTY NEW JERSEY
"AS BUILT"
SANITARY SEWER SYSTEM — STAGE 2
PLAN & PROFILE
BOSWELL ENGINEERING CO.
RIDGEFIELD PARK NEW JERSEY
PAGE 12

PLATE 2—DOUBLE PLAN-PROFILE O. P. N. A. S. E. STANDARD
E. L. RIDGWAY COMPANY, INC.
10154 A&G — MADE IN U.S.A.

BOROUGH OF ORADELL

SOLDIER HILL RD. (SHEET N

THOMAS & MARY ANN COX

R. KENNETH & HELEN ROBERTS

1020

JOE & GERALDINE Mc MANUS

RONALD & CAROL MARKS

KENNETH & ADELE MALES

HUYLER ST.

DROP MH. NO.12

8" ACP CLASS 2400

BIT. PAVT.

MUNSEY RD.

M.H NO. 13

M.H NO. 14

M.H NO. 15

APPROXIMATE LOCATION OF TRANSCONTINENTAL PIPE LINE

HENRY & VIRGINIA SNALL

LOUIS & JEANNE VISOUROUX

HARRY & DOROTHEA NEINSTADT

HARRY & CLARA DUFFY

1022

JAMES & DOROTHY Mc CONAGHY

CHARLES & GERTRUDE DICKSON

JOSEPH & BERTELL ZONDRDZNY

LOT 1

LOT 2

LOT 3

LOT 4

LOT 5

LOT 6

LOT 7

LOT 8

LOT 9

LOT 10

LOT 11

PLAN

1" = 30'

BSMT = 8/105

STORM = 8/106

DROP MH. NO.12
TOP 107.92
FL 97.77
FL 97.92
FL 101.72

M.H NO.13
TOP 110.77
FL 102.86

M.H NO.14
TOP 113.89
FL 106.57

M.H NO.15
TOP 117.09
FL 108.73

8" A.C.P. CLASS 2400
L = 299.34'
GR = 1.51%

8" A.C.P. CLASS 2400
L = 273.33'
GR = 1.92%

8" ACP CLASS 2400
L = 325.66'
GR = 0.91%

299.80'

273.30'

325.66'

PROFILE

HOR. 1" = 50'

VERT. 1" = 10'

PROFILE/10

BOROUGH OF EMERSON
NEW JERSEY

SANITARY SEWER SYSTEM — STAGE 2

PLAN & PROFILE

"AS BUILT"

BOSWELL ENGINEERING CO. — RIDGEFIELD PARK, N.J.

DRAWN B.P. SCALE AS SHOWN SHEET NO. 5

CHECKED J.M. DATE ~~JUN~~ 1965 SEP 1966

PLATE 1—PLAN—PROFILE O. P. H. & A. E.
100% HIS PAPER—INKS AND PRINTS AS N. L. A.
CHARLES BRUNING COMPANY, INC.

RK 1 PA.4

ARTHUR & ROSE ZIMMERMAN

CORA G. MODELL

VICTOR & MARILYN TOMICKI

#142 SL-12
E-131.09

#110 S.L.
E-127.45

#118 S.L.
E-126.79

WURTSEY RD.

PLAN
1" = 30'

PROFILE
HOR. 1" = 30'
VERT. 1" = 3'

BOROUGH OF EMERSON
NEW JERSEY

SANITARY SEWER SYSTEM - STAGE 2

PLAN & PROFILE

"AS BUILT"

BOSWELL ENGINEERING CO. RIDGEWOOD, N.J.

DRAWN B.B. SCALE 30'

CHECKED J.H. DATE

SHEET NO. C

LOT 8 — SU AN HOMES

LOT 9 — HAROLD & ZENA KATZ

LOT 10 — BERNARD & HAE SHERMAN

LOT 11 — EDWARD & THELMA KENNEDY

LOT 12 — BYRON & JOAN LEDGERWOOD

LOT 13 — HENRY & PAULA FLINK

LOT 14 — ARTHUR & DOROTHY HENDRIX

LOT 15 — NORMAN & SYLVIA SIEBERT

LOT 16 — VINCENT & MARY LO BUE

LOT 7 — NATHANIEL & RENEE GOLDBERG

LOT 8 — SAMUEL & SUSANNE PETRIX

LOT 9 — JOHN & ETTA FRIEND

LOT 10 — VICTOR & MARILYN TOMICKI

HOWARD & THELMA WOLLIN

1017

1019

1021

#44 SL-B B=144.32

#36 R-B GAR=142.84

#28 R-B GAR=141.78

#20 2S-B GAR=143.12

#12 R-B GAR=140.79

#4 SL B=134.83

#149

#132 SL-B B=146.85

#125 2S B=145.01

#123 B=141.47

#142 SL-BF B=132.08

#147 SL BF B=132.08

SL #112 B=131.01

DRAINAGE EASEMENT

S. SANITARY SEWER EASEMENT ACC. TO DEED 2460

LONGVIEW DR.

HILL RD.

ROSS AVE.

MUNSEY RD.

M.H. NO. 22-B

M.H. NO. 22

M.H. NO. 22A

M.H. NO. 21

M.H. NO. 20

M.H. NO. 19

M.H. NO. 29

8" A.C.P. CL. 2400 S1.40% 216.00'

8" A.C.P. CL. 2400 S1.40% 260.80'

149.25' 6" CI

L.H. 123

L.H. 125

L.H. 147

L.H. NO.

PLAN

1" = 30'

BSM = 9.106

PROFILE

HOR. 1" = 50'

VERT. 1" = 10'

FROM 2716

M.H. NO. 29 TOP 142.22 FL 136.22

M.H. NO. 22 TOP 141.52 FL 134.62

M.H. NO. 22A TOP 142.30 FL 136.70 FL 134.80

M.H. NO. 21 TOP 146.33 FL 136.84

M.H. NO. 20 TOP 139.16 FL 136.85

M.H. NO. 22A TOP 142.30 FL 136.70 FL 136.50

M.H. NO. 22B TOP 146.71 FL 142.61

8" A.C.P. CLASS 2400 GR 0.50%

8" A.C.P. CLASS 2400 GR 0.50%

8" A.C.P. CLASS 2400 GR 0.55%

L = 154.80 8" A.C.P. CLASS 2400 S 1.61%

33.1 15.6 248.60 200.80 150.70

PLAN (SHOWN) NOTED NOTE ROOF, GARAGE & PORCH FLOOR EL'S No. STRUCTURE LOCATIONS CHECKED

PROFILE (SHOWN) NOTED NOTE ROOF, GARAGE & PORCH FLOOR EL'S No. STRUCTURE LOCATIONS CHECKED

BOROUGH OF EMERSON
NEW JERSEY

SANITARY SEWER SYSTEM — STAGE 2

PLAN & PROFILE

"AS BUILT"

HUSSEY PROPERTIES CO., RIDGEFIELD PARK, N.J.

DRAWN E.B. DATE MAR. 1960

CHECKED E.H. SCALE AS SHOWN SHEET NO. 7

PLATE 1—SINGLE PLAN—PROFILE O. P. R. & B. F. STANDARD

PLAN
PROFILE
SURVEYED
PLOTTED
NOTE BOOK
ALIGNMENT CHECKED
RT. OF WAY CHECKED
NO.
BY
DATE

LOT 1 — ELIAS & SUZANNE FRAVE — #80 1S. B.F. B= 36.05
FRANK & NORMA TRUPPI — #88 1S. B.F. B= 135.07
LOT 2 — EUGENE & GLADYS O'BRIEN — #102 SL. B.F. B= 135.82
MILTON & HANNAH PUTTERMAN — #110 1S. B.F. B= 136.19
MARTIN & ROSLYN HEIDMAN — #116 SL. B.F. B= 135.66
PHILLIP & CONCETTA RUSSO — #124 1S. B.F. B= 137.26
JOSEPH & LOUISE LUFT — #132 SL. B.F. B= 135.12
SAMUEL & SUSANNE PETRIX — #142 SL. B.F. B= 138.22
SEE SHEET 7
BROOK ST.
ROSS AVENUE
M.H. NO. 28
M.H. NO. 29
M.H. NO. 23
M.H. NO. 21
HILL RD.
SEE SHEET 8
ALEXANDER & STEVE GRODSKI — #88 1S. B.F. B= 131.68
HERBERT & RITA KAUFMAN — #98 1S. B.F. B= 131.37
BRUNO & IRMA ALFIERI — #105 1S. B.F. B= 131.66
HAROLD & FRANCES PECK — #113 1S. B.F. B= 131.80
SARA PRAGER — #121 SL. B.F. B= 133.49
WILLIAM & JEANNE CORTILL — #129 SL. B.F. B= 134.32
JARDIN & LINDA ROSENCRANZ — #137 1S. B.F. B= 134.68
JAMES & ETTA FREED — #147 SL. B.F. B= 139.08

PLAN
1" = 30'
HORIZ. 1" = 30'
VERT. 1" = 10'

M.H. NO. 25 — UP 125.23 — FL 125.11 — FL 120.99
M.H. NO. 24 — UP 135.36 — FL 135.24 — FL 130.84
M.H. NO. 23 — UP 138.66 — FL 138.54 — FL 134.14
M.H. NO. 22 — UP 141.66 — FL 141.54 — FL 137.14
M.H. NO. 21 — UP 144.66 — FL 144.54 — FL 140.14
8" VCP CLASS 2400 @ 0.4%
394.40
143.05

PROFILE
HORIZ. 1" = 30'
VERT. 1" = 10'

BOROUGH OF EMERSON
NEW JERSEY
SANITARY SEWER SYSTEM - STAGE 2
PLAN & PROFILE
"AS BUILT"
BOSWELL ENGINEERING CO. - RIDGEFIELD PARK, N.J.
DRAWN B.B.
CHECKED J.B.
SCALE AS SHOWN
DATE SEPT. 20 1955 1956
SHEET NO. 2

42-141

PLATE 1—PLAN—PROFILE O. F. M. & A. E.
1005 RAG PAPER—MADE AND PRINTED IN U. S. A.
CHARLES BRUNING COMPANY, INC.

BOROUGH OF CRADELL
SOLDIER HILL RD.
LONGVIEW DR.
RCES 6 AVE.
HUYLER ST.
MATCH LINE
STA. 8+75
SEE SHEET 6
SEE SHEET 12
SEE SHEET 8

LOT 1 — FRANCES REID
LOT 2 — MILAN & HELEN DEVACKA
LOT 3 — HAROLD & HELENE BLAUSTEIN
LOT 4 — LAWRENCE & GERTRUDE GALDWIN
LOT 11 — EDWARD & JANE GUARINO
LOT 10 — RALPH & LORE LEVI
LOT 9 — WILLIAM JR & EMMA SHELLEY
LOT 8 — ALBERT & CLAIRE DE FRESSINE
LOT 7 — ANNA CARR ET AL
LOT 6 — EDWARD & DIANA ILG
LOT 5 — MINAS & ROSEMARY VLAHACOS
LOT 4 — JACOB & SARAH FY BOND
LOT 3 — E.T. EBERHARDT
LOT 2 — CHAS. & ANNA LIEBERFELD
LOT 1 — CARL W. & RUTH RUBING

M.H. NO. 35 — RIM 132.17 — INV. 123.34
M.H. NO. 36 — RIM 142.17 — INV. 134.01
M.H. NO. 26 — RIM 124.96 — INV. 113.91
PROP. M.H. NO. 27 — TOP 137.12 — FL. 123.99 — FL. 121.81
M.H. NO. 25 — TOP 135.23 — FL. 126.97 — FL. 125.41
PROP. M.H. NO. 28 — TOP 129.76 — INV. 119.91 — INV. 117.36

8" V.C.P. @ 2.00% — 389.45'
8" V.C.P. @ 2.58% — 172.58'
8" V.C.P. @ 0.58% — 382.75'

PLAN
1" = 30'
BOARD'S SWM
STORM SEWER

PROFILE
HOR. 1" = 30'
VERT. 1" = 10'
DATUM = 2210

BOROUGH OF EMERSON
NEW JERSEY
SANITARY SEWER SYSTEM - STAGE 2
PLAN & PROFILE
"AS BUILT"
BOSWELL ENGINEERING CO. - RIDGEFIELD PARK, N.J.
DRAWN: E.B.
CHECKED: J.B.
SCALE: AS SHOWN
DATE: JAN. — MAR. — SEP. 1956
SHEET NO. 9

PLAN: SURVEYED — PLOTTED — NOTE BOOK — NO. — LAYOUT CHECKED — ALL OF WAY CHECKED — BY — DATE

PROFILE: SURVEYED — PLOTTED — NOTE BOOK — GRADES CHECKED — & AS NOTED — STRUCTURE LOCATIONS CHECKED — BY — DATE

42-141

PLATE 1—PLAN—PROFILE O. P. R. A. R. S.
100% No 1 PAPER—MADE AND PRINTED IN U. S. A.

FRANK & GLORIA MAGYER

RALPH & DIANE LA MONTE

EUGENE & GLADYS O'BRIEN

CARL W. & RUTH RUBING

LEONARD & RITA ELIAS

JOHN & FLORENCE HUGHES

BROOK ST.

LONGVIEW DR.

ROSS AVE.

MUNSEY RD.

HUYLER ST.

DROP M.H. NO 32

DROP M.H. NO 33

M.H. NO 35

M.H. NO 5

S.D. NO 12A

SYPHON DROP

8" ACP CLASS 2 340.30'

8" ACP CLASS 2 124.20'

8" ACP CLASS 2 175.80'

#73 1.25 B-136.07

#57 1.25 B-136.35

#24

#17

#18

#19

#6

ANTHONY & VELMA SCHULZ

FRANK & NORMA TRUPPI

CHAS. & ANNA LIEBERFELD

JOSEPH & BERTELL ZODGRODZNY

PLAN
1" = 30'

PROFILE
HOR. 1" = 50'
VERT. 1" = 10'

DROP M.H. NO 32
INV. 130.79
I.P.F. 132.5
F.F. 139.44'

M.H. NO 35
INV. 127.23
F.L. 134.82
F.L. 135.41

DROP M.H. NO 33
INV. 131.2
F.F. 143.99
F.F. 131.66

M.H. NO 5
INV. 117.19
F.L. 128.38

340.30'

124.20'

175.80'

BROOK ST.

HUYLER ST.

PLAN
SURVEYED
PLOTTED
NOTE BOOK
NO.
BY
DATE
ELEVATIONS CHECKED
ALIGNMENT CHECKED
RT. OF WAY CHECKED

PROFILE
SURVEYED
PLOTTED
NOTE BOOK
NO.
GRADES CHECKED
ALIGNMENT CHECKED
STRUCTURE LOCATIONS CK'D.

BOROUGH OF EMERSON
NEW JERSEY

SANITARY SEWER SYSTEM — STAGE 2

PLAN & PROFILE

"AS BUILT"

BOSWELL ENGINEERING CO. RIDGEFIELD PARK, N.J.

DRAWN S.B.
CHECKED J.H.
SCALES 1" = 30' & 1" = 10'
DATE 8-58
SHEET NO. 10

12-141

PLATE 1—PLAN—PROFILE © P.N.B.K.E.
100% RAG PAPER—MADE AND PRINTED IN U.S.A.
CHARLES BRUNING COMPANY, INC.

BM #2 - ELEV 135.47
2" OFF CATCH BASIN - NW.
INTERSECTION OF BROOK ST. &
LONGVIEW DRIVE
SQUARE CUT IN CURB

PLAN
SURVEYED
PLOTTED
PROFILE CHECKED
NOTE BOOK
NO.
BY
DATE

PROFILE
SURVEYED
PLOTTED
GRADE CHECKED
NOTE BOOK
NO.
STREET WIDTH
BY
DATE

LONGVIEW DR.

FRANK & GLORIA MAGYER
SIDNEY & ISABEL DEENER
ROBERT C HORDWYTZ
JOHN S. & CHARLES LYNCH
JOSEPH & SANDRA GOTTESMAN
JEROME & JOYCE NITKEE
HAROLD & ZENA KATZ
SU AN HOMES
SL-B B-140.86
RALPH & DIANE LA MORTE
JEROME & LOIS DORFMAN
THELMA JALOWSKY
ALEXANDER & CATHRYN ZWAIN
LEE & CARMEN LINK
NATHAN & ZENEE GOLDBERG
HOWARD & THELMA WOLLIN
BROOK ST.
HILL RD.
SEE SHEET 7
SEE SHEET 6

DROP M.H NO. 32
M.H NO. 31
M.H NO. 30
M.H NO. 29
M.H NO. 28
M.H NO. 27
M.H NO. 22

8" SDR 35 @ 2.40%
249.05'
8" ACP CLASS 2400 @ 0.58%
8" ACP CLASS 2400 @ 0.50%
8" ACP CLASS 2400 @ 0.72%

PLAN
JOSEPH & ANGELINE HASTRO
BGM #3 3.13
STORM #11

PROFILE
HOR. 1" = 50'
VERT. 1" = 10'
PROF. 27.5

BOROUGH OF EMERSON
NEW JERSEY
SANITARY SEWER SYSTEM - STAGE 2
PLAN & PROFILE
"AS BUILT"
BOSWELL ENGINEERING CO. - RIDGEFIELD PARK, N.J.
DRAWN Y.B. SCALE AS SHOWN SHEET NO. 5
CHECKED J.B. DATE JAN 1966

PLATE 1—PLAN—PROFILE O. P. A. & R. E.
1935 RAG PAPER—MADE AND PRINTED IN U. S. A.

NATHAN & EDITH JAFFEE

IRVING & FAY STREISANT

GERALD & DANE MORRIS

WALTER & MARGARET KEENAN

THOMAS & ANNA LYNCH

BERNARD & EVE MORCHEN

#22 1½ S.
B=134.49

#30 1½ S.
B=134.64

#38 1½ S.
B=134.48

#46 1½ S.
B=135.04

#54 1½ S.
B=136.15

-25

M.H. NO. 34

M.H. NO. 32

M.H. NO. 33

LONVIEW DR.

#25 1½ S.
B=136.94

#33 1½ S.
B=135.61

#41 1½ S.
B=136.76

#49 1½ S.
B=135.36

ANTHONY & MARY MAJRICH

HILLIARD & WINFRED LAWLOR

HARVEY & BETTY ANTON

AUGUST & BEVERLY FERRIS

ARTHUR & WILMA SCHULZ

BORO OF EMERSON

MATCH LINE

STA. 6+00

SHEET 11

PLAN
1" = 30'
BSMT = 9/113
STORM = 8/106

PLAN	SURVEYED	BY	DATE
NOTE BOOK	PLOTTED		
NO.	LINES CHECKED		
	RT. OF WAY CHECKED		

M.H. NO. 31
TOP 139.12
F.C. 129.12

M.H. NO. 33
TOP 136.12
F.C. 126.74

DROP M.H. NO. 32
TOP 133.79
F.C. 124.35
F.C. 124.91

8" RCP

8" ASB L=160.30' S=2200 n=0.009

8" ASB CLASS L=393.27' S=3400 GR=3.20%

160.30

393.27

140

130

120

PROFILE
HOR: 1"=50'
VERT: 1"=10'
PROP. 2715

PROFILE	SURVEYED	BY	DATE
NOTE BOOK	PLOTTED		
NO.	LINES CHECKED		
	R/W & STRUCTURE NOTATIONS CHKD.		

0 1 2 3 4 5 6 7 8

PLATE 1—PLAN—PROFILE S.P.N. & R.E.

BOROUGH OF EMERSON
NEW JERSEY

SANITARY SEWER SYSTEM - STAGE 2

PLAN & PROFILE

"AS BUILT"

BOSWELL ENGINEERING CO. RIDGEFIELD PARK, N.J.

DRAWN B.B. SCALE 1" = 30' SHEET NO. 12

CHECKED J.H. DATE SEPT 1966

PLAN
SURVEYED
NOTED
NOTE BOOK
No.
DRAWING CHECKED
R. of WAY CHECKED

SOLDIER HILL RD

LOT 5

LOT 6
TULLIA LEONARD

MH. NO. 99

LOT 6A
TULLIA LEONARD

LOT 7

F.W. RAGE

WENDEL PL.

PLAN
SCALE 1"=50'

SEE SHEET 2

SOLDIER HILL RD

JOHN & MARY DAY

1000
2-S.F.
W.B.O.G.

1001

MH NO 47
-52

LOT 8

PINEMORE PLACE

8" ASP CLASS 3300
324.30'

SAN. SEWER EASEMENT

8" ASP CLASS 3300
63.20'

M.H. NO. 79

M.H. NO. 79A

8" ASP CLASS 3300
184.90'

M.H. NO. 76

M.H. NO. 77

JORDAN RD.
SEE SHEET 2

W O O D S

W O O D S

CHANDLER CONSTRUCTION CO.

LOT 9

1000 S.L.
B-75.96

1142 S.L.
B-75.07

1135 S.L.
B-75.98

PLAN
SCALE 1"=50'
ESMT. -/11
STORM-1/11

PROFILE
SCALE HOR. 1"=50'
VERT. 1"=10'
PROF. 9764

PROFILE
SCALE HOR. 1"=50'
VERT. 1"=10'

M.H. NO 47
TOP 102.02
FL 92.0

M.H. NO 48
TOP 91.19
FL 82.69

M.H. NO 97
TOP 91.91
FL 84.76
FL 81.71

M.H. NO 79
TOP 81.23
FL 75.93

M.H. NO 79A
TOP 77.23
FL 72.83

M.H. NO 76
TOP 77.38
FL 65.47

M.H. NO 78

222.38'

324.30'

63.20'

184.90'

PROFILE
NOTED
NOTE BOOK
No.
GRADE CHECKED
8" A.C. NOTED
CONSTRUCTION OFFICIAL

BOROUGH OF EMERSON
NEW JERSEY

SANITARY SEWER SYSTEM - STAGE 2

PLAN & PROFILE

"AS BUILT"

BOSWELL ENGINEERING CO. - RIDGEFIELD PARK, N.J.

DRAWN R.B. SCALE AS SHOWN SHEET NO. 3

CHECKED V.B. DATE SEP 1960

PLATE 1-SINGLE PLAN-PROFILE O. P. R. & R. E. STANDARD
C. L. RIDGWAY COMPANY, INC.

MATCH SHEET 17 LINE

ROBERT H & NANCY C WILSON — #7 S.L. B=125.33

JOHN & LILLIAN ZABEISKIE — #17 S.L. B=125.75

WILLIAM & JEAN WEBER — #25 S.L. B=126.92

FRED & RITA CLAUSS — #33 S.L. B=128.61

HAROLD & [illegible] RAPHAELAT — #43 S.L. B=128.16

DAVID & GLORIA [illegible] — #51 S.L. B=129.28

ROBERT & JOAN KRAMER — #59 S.L. B=130.91

A.P.E BROWN — #69 S.L. B 131.31

APPROXIMATE LOCATION OF TRANSCONTINENTAL GAS PIPE LINE

LOT 19 | LOT 18 | LOT 17 | LOT 16 | LOT 15 | LOT 14 | LOT 13

COLONIAL RD

M.H. NO 51 | M.H. NO 52 | M.H. NO 53 | M.H. NO 54 | M.H. NO 55 | M.H. NO 56

399.80 | 225.00 | 174.50 | 184.50

BACP CLASS 24 | BACP CLASS 24 | BACP CLASS 24

PENNSYLVANIA

1006

RONALD & JUNE DE LAMERE — #6 S.L. B=130.93

WILLIAM & FLORENCE THOMAS — #20 S.L. B=130.93

JOHN & ASSUNDA GAGNISH — #26 S.L. B=131.24

JOHN & EMILY BORSTELMANN — #36 S.L. B=130.00

EDWIN & ELIZABETH BUSSELL — #48 S.L. B=134.24

ELSIE S [illegible] — #52 S.L. B=138.03

MORTIMER & DOROTHY GARRIGAN — #62 S.L. B 138.89

ELMER & AGNES PECHT — #70 S.L. B=142.98

LOT 2 | LOT 3 | LOT 4 | LOT 5 | LOT 6 | LOT 7 | LOT 8 | LOT 9

CONCORD ST

PLAN
SCALE 1"=30'
BSMT 9/15
ST 9/14 9/15

PROFILE
SCALE HOR. 1"=30'
VERT 1"=6'

"AS BUILT"
P.P.
J.H.
SEP 1966

PLAN
SURVEYED
PLOTTED
NOTE BOOK
NO.
LAYOUT CHECKED
RT. OF WAY CHECKED
BY
DATE

PROFILE
SURVEYED
PLOTTED
NOTE BOOK
GRADES CHECKED
R.I.'s NOTED
STRUCTURES LOCATED
NO.
BY
DATE

PLATE 1—PLAN—PROFILE O. P. B. D. R. K.
1965 MAP PAPER—MADE AND PRINTED IN U.S.A.
CHARLES BRUNING COMPANY, INC.

PLAN
SURVEYED
PLOTTED
NOTE BOOK
GRADES CHECKED
AS BUILT
R. OF WAY CHECKED
NO.
DATE
BY

PROFILE
SURVEYED
PLOTTED
NOTE BOOK
GRADES CHECKED
AS BUILT
STRUCTURE NOTES CHKD
NO.
DATE
BY

LOT 8 — JOHN & DOROTHY MUIR — #126 — B. 74.4
LOT 7 — ROBERT & ELLA WHITE — #134 — B. 77.6
LOT 6 — FRED & MONA B GOLD — #130 — B. 84.2
LOT 5 — M & J. BERNHART — #122 — B. 93.3
LOT 4 — #100
1002
LOT 3 — S=125.7
LOT 2 — B. 136.1
LOT 1 — JOHN & FLORENCE HARRIMANN
1001
BM #3 - ELEV 122.651
EAST CORNER OF DRIVE
100 COLONIAL ROAD
SQUARE CUT IN CURB
WARREN & GLORIA BEASON
ANTHONY & EDITH DIONISIO
M.H. NO.
COLONIAL RD
8" ACP CLASS 2400
221.25'
CONC CURB
CONC CURB
M.H. NO 65
M.H. NO 66
M.H. NO 58
M.H. NO 64
8" ACP CLASS 2400
115.55'
8" ACP CLASS 2400
167.10'
8" ACP CLASS 2400
249.15'
8" ACP CLASS 2400
MATT LINE
STA 15+50
SEE SHEET 15
SEE SHEET 13
SEE SHEET 14
CONGRESS RD
CONCORD ST.
BIT PAVT.
CONC CURB
FRANK & HELEN DE LUGA
#84
#76
#68
#60
#52
#44
#36
#28
#20
#12
#4
-29
-28
-27
-26
1004
1003
1002
1001
GERALD & DOROTHY CORRIGAN — LOT 14
AUGUST & HELEN DHUYVETTERS — LOT 13
ERWIN & DOROTHY HOCK — LOT 12
MATHEW & ROSE ARMSTRONG — LOT 11
WM. & MAE BUTTLING — LOT 10
GEORGE & ELIZABETH WRIGHT — LOT 10
ABE & AUDREY PIRACCI — LOT 9
EDWARD & VERA SINGER — LOT 11
LOUIS & ELIZABETH BENDER — LOT 12
LOT 9

PLAN
SCALE: 1"=50'
BSMK 97.16 - 3.07
STORM SYNC - 8.07

PROFILE
SCALE: 1"=50' HOR. 1"=5' VERT.
PROF. 124

MH NO 65 — TOP 98.80 — FL 90.80
MH NO 66 — TOP 96.37 — FL 86.17
MH NO 58 — TOP 98.57 — FL 89.91 — FL 89.71
MH NO 64 — TOP 98.9 — FL 89.4

BOROUGH OF EMERSON
NEW JERSEY
SANITARY SEWER SYSTEM - STAGE 2
PLAN & PROFILE
"AS BUILT"
DES. B.B. SCALE AS SHOWN SHEET NO. 5
CHK'D. P.N. DATE SEPT. 1966

42-141
PLATE I-PLAN-PROFILE G. P. H. & R. E.

RICHARD & LA VERNE HABERSKI

FRANK & MARY CURATOLO

EDWARD & HELEN MADIGAN

KARL & MARTHA BOBERCK

RAMAZAN ŞOBJA

JAMES & SARA FALK

NANCY LEMOKE

FREDERICK & DOROTHY VOLBERT

FRANCIS & AGNES VAN NESTRAND

ROY & ELIZABETH VASEL

WALTER & MARIE WILLIAMSON

CHAS. & CLARA HEIRT - JENNIE SCOTTI

RICHARD & ESTER LEE

WASHINGTON AVE.

HANCOCK ST.

ALAN RD.

FOREST AVE.

COLONIAL RD.

M.H. NO. 68

M.H. NO. 69

M.H. NO. 70

M.H. NO. 67

M.H. NO. 67A

L.H. NO. A

L.H. NO. B

1014

1013

1012

1003

SEE SHEET 23

SEE SHEET 20

SEE SHEET 24

SEE SHEET 24

SEE SHEET 24

MATCH LINE SEE SHEET 20 STA 15+25

MATCH LINE SEE SHEET 24 STA 15+50

"210 15 B=67.66

"202 15.

"186 1½ S. B=68.56

"178 15 B=67.06

"170 15 B=70.27

"154 15.

"208 1½ S. B=69.26

"201 15.

"185 1½ S. B=68.88

"185 1½ S

"177 1½ S.

"169 1½ S

"161 1½ S B=70.07

8" ACP CLASS 3300

6" ACP CLASS 3300

446.246.65'

161.00'

157.00'

88.15'

PLAN

SCALE: 1"=30'

PROFILE

SCALE: HOR. 1"=30'
VERT. 1"=10'

NEW JERSEY

SANITARY SEWER SYSTEM - STAGE 2

PLAN & PROFILE

"AS BUILT"


DRAWN E.P. 30 SCALE AS SHOWN SHEET NO. 19

CHECKED D.M. DATE JAN 1965

SEP 19 1966

PLATE 1 - PLAN - PROFILE O.F.B.-B.R.E.
100% RAG PAPER MADE AND PRINTED IN U.S.A.
CHARLES BRUNING COMPANY, INC.

42-141

PLAN
SURVEYED
PLOTTED
NOTE BOOK
NO.
BY
DATE
ALIGNMENT CHECKED
ELEV. CHECKED
STRUCTURE NOTES CHECKED

PROFILE
SURVEYED
PLOTTED
NOTE BOOK
NO.
BY
DATE
GRADES CHECKED
ALIGNMENT CHECKED
STRUCTURE NOTES CHECKED

LOT 1 — JACK & NAIL LEMMON

LOT 2 — CHAS. JR & ELEANOR LOWELL

LOT 3 — EDWARD & DOROTHY DAWE

LOT 4 — MATTHEW & SYLVIA STOLARZ

LOT 5 — FREDERICK & ALICIA WOLLEN & LLOYD & MILDRED SMITH

LOT 6 — ANNE E. LOCKER

LOT 7 — FRANK & HELEN TOLVE

LOT 8 — HERBERT & PATRICIA NATHAN

BOROUGH OF CRADELL

SOLDIER HILL RD.

CONGRESS RD.

STATE LINE

SHEET 1

MH NO 54

MH NO 55

MH NO 56

JAMES & RUTH MCINTOSH — LOT 1

CAROLYN E. BRICKWELL — LOT 2

CAMPBELL & JEANNE MCCARTHY — LOT 3

EDWARD & FLORENCE PIERCE — LOT 4

DAVID LEWIS — LOT 5

HUGO & HILMA GIDSON — LOT 6

ALBERT & DOROTHY GAMBUN — LOT 7

ALAN & HILDEGARD GREELEY — LOT 8

PLAN

Scale 1" = 40'

PROFILE

Scale Horiz. 1" = 40'
Vert. 1" = 4'

PLATE 1—PLAN—PROFILE


NEW JERSEY

SANITARY SEWER SYSTEM — STAGE 2

LAT. & PROFILE

"AS BUILT"

B.B. J.N.

SCALE AS SHOWN

DATE JAN 1965

SEP 1970

SHEET NO. 17

MATTHEW & ROSE ARMSTRONG

LOT 10

FRANK & JR & MARJORIE MANLEY

WM & MAE BITTLING

LOT 5

M E J BERNHAUT

JACK & AVIS PETERSON

MAXWELL & EVELYN SCRIBER

EDWIN & MARIA O'NEILL

ROE [illegible] & JANET R. LESTERY

SEE SHEET 15 STA. 1+25

SHEET 24

LEXINGTON AVE

EVERETT AVE

CONKLIN RD

M.H. NO. 58A

M.H. NO. 59

M.H. NO. 60

M.H. NO. 61

M.H. NO. 6

MATCH LINE STA. 9+00

MATCH LINE STA. 19+00

SEE SHEET 15

ABEL & AUDREY PIRACCI

GEORGE & ELIZABETH WRIGHT

WARREN & GLORIA BEASON

MICHAEL & ANN LEMMA

ALANE RO ALEX & S.D. BANCROFT

ROBERT & KATHRYN [illegible]

ANASTES & HELEN ALEXIADES

DAVID & JEAN MOIR

FREDERICK & DOROTHY VAN RASSEL

LOT 10

PLAN

SCALE 1" = 30'

PROFILE

HORIZ. SCALE 1" = 30'

VERT. SCALE 1" = 5'

PLAN	
SURVEYED	
DRAWN	
NOTE BOOK	ALIGNMENT CHILLED
	ST. OF WAY CHILLED
NO.	

PROFILE	
SURVEYED	
DRAWN	
NOTE BOOK	GRADE CHILLED
	B. K.'s NOTED
NO.	STRUCTURE NOTES NOTED



SANITARY SEWER SYSTEM - STAGE 2

PART 2 P.C. 6

"AS BUILT"


DRAWN H.B. SCALE AS SHOWN SHEET NO. 16

CHECKED T.H. DATE [illegible]

SEP 1965

PLATE 1 - PLAN - PROFILE

JOHN NAD PAGE - VOSE AND FARMER PRINTING

CHARLES BRUNING COMPANY, INC.

42-141

LOT 1 — ROY & MARGARET EVERSON — LOT 2 — EDWARD & JEANETTE WIEST — 903 — LOT 3 — PAUL & RUBYMAE JANSAK — LOT 4 — KENNETH & GLORIA FORNABAI

LOT 1 — HENRY & MILDRED BARTELLS — LOT 2 — JOHN & LILLIAN LONG — 904 — LOT 3

WALNUT AVE.

CONGRESS RD.

JOSEPH & RUTH HYLAND — LOT 2 — R.S.E. ESTELLA CIMPA

LOT 1 — 1035 — SEE SHEET 28

M.H. NO. 94 — M.H. NO. 95 — M.H. NO. 96 — M.H. NO. 97 — M.H. NO. 98

ROALD & ASTRID SVERDRUP — LOT 10

CHAS & ANNA BRUNJE — LOT 2 — T. HARRY & MARIE WHITE — LOT 3 — 1009 — ROBERT & PATRICIA BANNISTER — LOT 4 — DANIEL & MILDRED MONAHAN — LOT 5 — ROBERT, CHAS, & MAY MORSE — LOT 6 — MARTIN EGLOR A. REINISH — LOT 7

MAT-H

PLAN
SCALE 1"=30
DSM 7/08
STORM 7/08

PROFILE
SCALE HOR 1"=50
VERT 1"=10
PROF 7/15

L = 401.02

400.95 — 167.60 — 203.00

NEW JERSEY
SANITARY SEWER SYSTEM - STAGE 2
PLAN & PROFILE
"AS BUILT"
DRAWN B.B. SCALE AS SHOWN SHEET NO. 2
CHECKED J.H.K. DATE JAN 1956
SEP 1956

PLAN
SURVEYED
PLOTTED
NOTE BOOK ALIGNMENT CHECKED
NO. RT. OF WAY CHECKED
BY DATE

PROFILE
SURVEYED
PLOTTED
NOTE BOOK GRADES CHECKED
B.M.'s NOTED
NO. STRUCTURES LOCATING CK'ED
BY DATE

42-141

PLATE I—PLAN—PROFILE O. F. R. & R. C. E.

PLAN
SCALE: 1"=40'
STORM P-107

PROFILE
SCALE: HOR. 1"=40'
VERT. 1"=10'
STORM P-107

FOREST AVE.

SOLDIER HILL RD.

JORDAN RD.

POWELL RD.

BIT. PAVT.

8" A.C.P. CLASS 2400
219.00'

8" A.C.P. CLASS 2400
183.90'

M.H. NO. 74
104.58

M.H. NO. 73
T.O.P. 89.82
I.E. 83.42

M.H. NO. 73
T.O.P. 87.76
I.E. 77.66

M.H. NO. 72
T.O.P. 73.87
I.E. 68.97

M.H. NO. 72

M.H. NO.

MATCH LINE - SEE SHEET 16

SEE SHEET 13

SEE SHEET 22

SEE SHEET 22

35

PLAN
SURVEYED
PLOTTED
NOTE BOOK CHECKED
No. AS OF MAY CHECKED

PROFILE
SURVEYED
PLOTTED
NOTE BOOK CHECKED
No. AS OF MAY CHECKED
STRUCTURE NOTATIONS CHECKED

BOROUGH OF EMERSON
NEW JERSEY

SANITARY SEWER SYSTEM - STAGE 2

PLAN & PROFILE

"AS BUILT"

DESIGNED B.B. SCALE AS SHOWN SHEET NO. 22

CHECKED J.M. DATE JAN 1955
SEP 1956